


Somers & Hervey - Precinct 2

Beck Drive, Rassmusen, QLD

Landscape Documentation

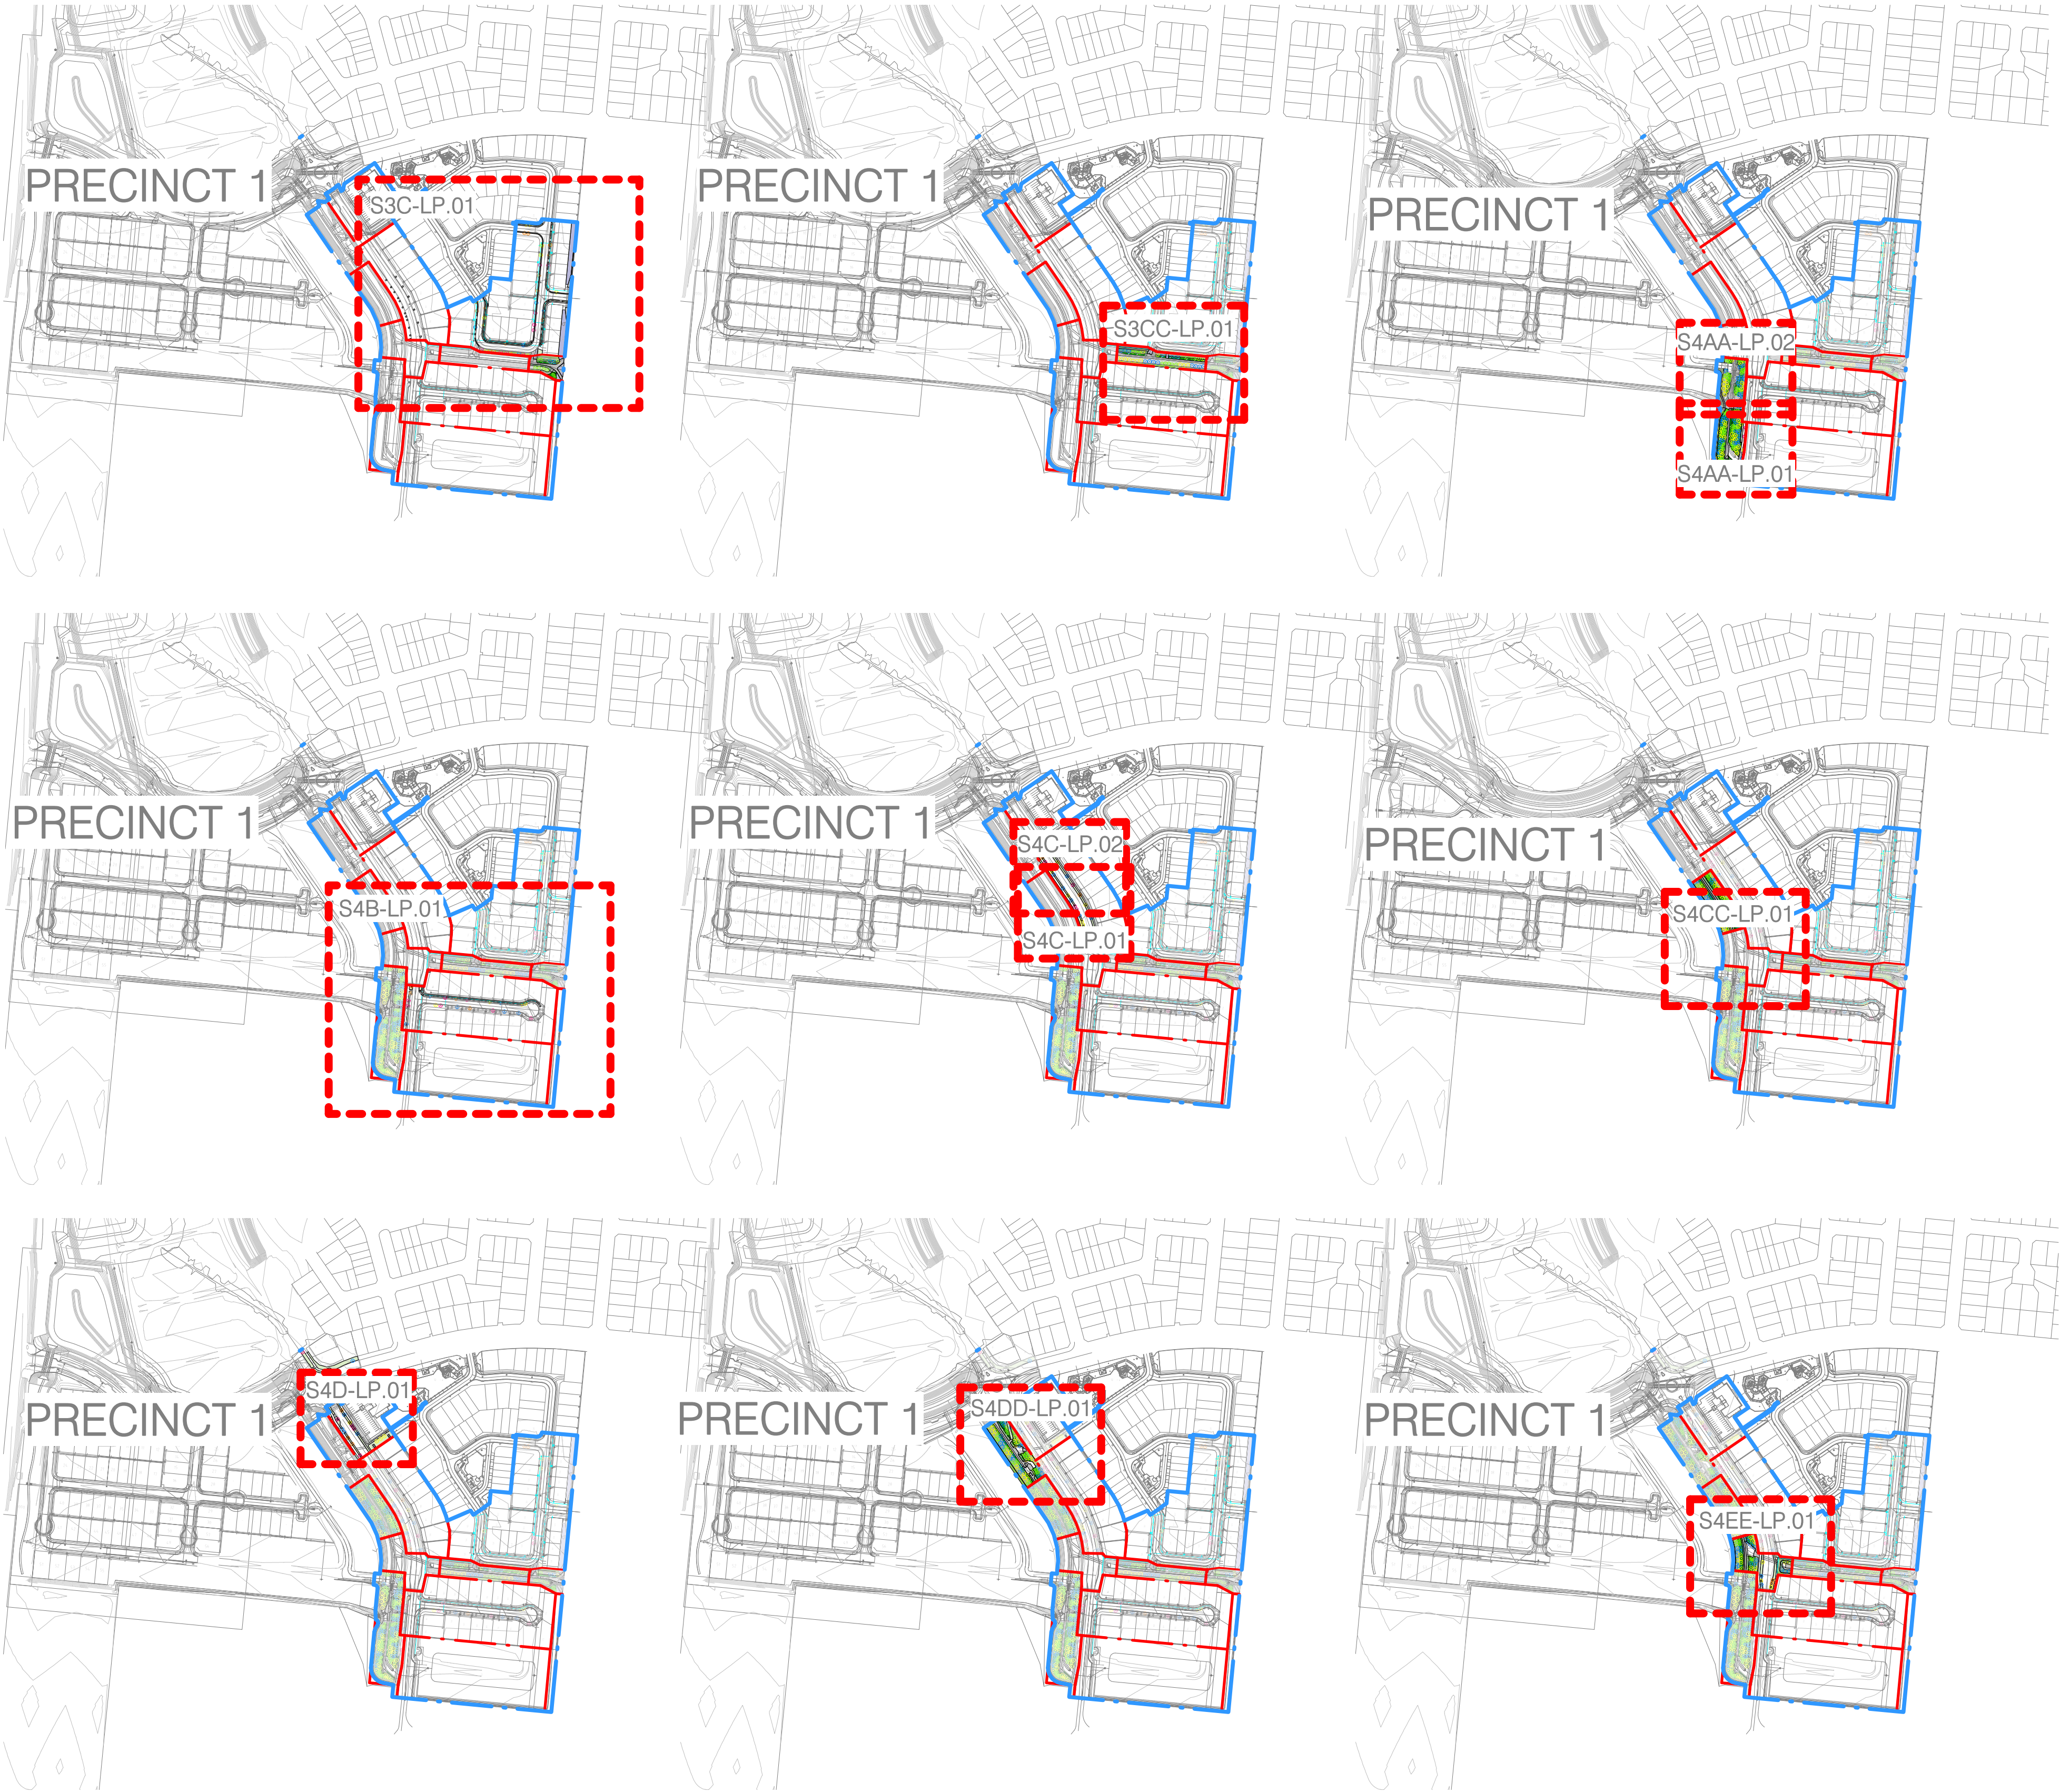

LEGEND

EXTERNAL WORKS

GENERAL

- EXTENT OF WORKS
- PROPERTY BOUNDARY

SOFTSCAPE

- TF1 - TURF ON GROUND
Refer Materials & Finishes Schedule
- TF2 - REINFORCED TURF
Refer Materials & Finishes Schedule
- PA3 - PLANTING AREA TYPE 3
Refer Materials & Finishes Schedule
- H1 - HYDROMULCH TYPE 1
Drain mix hydromulch (mowable)
- H2 - HYDROMULCH TYPE 2
Native mix hydromulch with tube tree stock @ 1/100 sq.m
- M1 - MULCH TYPE 1
Refer Materials & Finishes Schedule

DRAWING SCHEDULE

- CS.04 OVERALL STAGES 1-6
- CS.06 OVERALL TEMPORARY WORKS
- CS.01 COVER SHEET
- CS.02 PLANT SCHEDULE
- CS.03 MATERIALS AND FINISHES
- CS.05 OVERALL EMBELLISHMENT LEVELS
- S4AA-LP.01 LANDSCAPE PLAN 1 OF 2
- S4AA-LP.01. LANDSCAPE PLAN 1 OF 2 1
- S4AA-LP.02 LANDSCAPE PLAN 2 OF 2
- S4B-LP.01 LANDSCAPE PLAN 1 OF 1
- S4C-LP.01 LANDSCAPE PLAN 1 OF 2
- S4C-LP.02 LANDSCAPE PLAN 2 OF 2
- S4CC-LP.01 LANDSCAPE PLAN 1 OF 1
- S4D-LP.01 LANDSCAPE PLAN 1 OF 1
- S4DD-LP.01 LANDSCAPE PLAN 1 OF 1
- S4EE-LP.01 LANDSCAPE PLAN 1 OF 1
- S3C-LP.01 LANDSCAPE PLAN 1 OF 1
- S3CC-LP.01 LANDSCAPE PLAN 1 OF 1
- LD.01 DETAILS
- LD.02 DETAILS
- LD.03 DETAILS
- LD.04 DETAILS

GENERAL NOTES

- 1.0 These drawings must be read in conjunction with the full specification
- 2.0 These drawings must be read in conjunction with drawing package from the consultant team including all engineering drawings, architectural drawings and Arborist Specification.
- 3.0 Do not scale from these drawings - use figured dimensions.
- 4.0 SERVICES
Verify the 'as built' location of all existing services before excavation worksare started.
Services shown are indicitive only.
- 5.0 SURFACE LEVELS
Final surface levels to be varified on site. All adjacent surfaces are to be level and flush unless stated or documented otherwise.
- 6.0 FALLS
All pavement, planting & turf areas to be graded evenly. ponding is unacceptable.
- 7.0 MATERIALS & FINISHES
Refer Schedule Materials & Finishes in Specification for all elements contained within these drawings.
- 8.0 DESIGN FOR ACCESS AND MOBILITY
All external works to comply with AS 1428 Parts 1 & 4. Longitudinal grades no steeper than 1 in 20.1 and crossfall grades no steeper than 1 in 50.
- 9.0 PLANTING
Refer Planting Shchedule.

PAVEMENT FINISHES

- PT1 - PAVEMENT TYPE 1
Refer Materials & Finishes
- RP - ROCK PROTECTION
Refer Materials & Finishes
- CP - CONCRETE PROTECTION
Refer Civil Engineers Plans

EDGES

- E1 - EDGE TYPE 1
Refer Materials & Finishes
- MG - MAINTENANCE GATE
Refer Materials & Finishes
- HR1 - HANDRAIL
Refer Civil Engineers Plans
- F1 - FENCE TYPE 1
Refer to Details
- F2 - FENCE TYPE 2
Refer to Details
- F4 - FENCE TYPE 4
Existing fencing to be retained
- F5 - FENCE TYPE 5
Existing fencing to be retained

AS CONSTRUCTED

I, Timothy Connor, Registered Landscape Architect (AILA #3037), of RPS AAP CONSULTING PTY LTD, hereby certify that the landscape construction works, as shown on these 'As Constructed' drawings, reflect the changes that were made during installation.

[Signature]

rev no	description	date	drawn	approved
11	STAGE 3C - AS CONSTRUCTED	20260807	RKM	TFC
10	FOR CONSTRUCTION	20260717	LSG	TFC
9	FOR CONSTRUCTION	20260325	RKM	TFC
8	AMENDED OPW	20250828	RKM	TFC
7	REVISED ISSUE	20250124	EJO	TFC
6	AMENDED ISSUE	20241025	LRF	TFC
5	AMENDED ISSUE	20240910	BGS	TFC
4	AMENDED ISSUE	20240903	BGS	TFC
3	AMENDED ISSUE	20240902	BGS	TFC
2	AMENDED ISSUE	20240419	BGS	TFC
1	INITIAL ISSUE	20240412	BGS	TFC

PLEASE NOTE:
Annotiated dimensions take precedence over scaled dimensions. Contractors are to verify all dimensions on site before commencing any work or producing shop drawings. These drawings are protected by copyright and may not be copied or reproduced without the written permission of RPS' management. Refer to L0.00 (cover sheet) for RPS drawing disclaimer!



RPS AAP CONSULTING PTY LTD
ACN 117 883 173
ABN 97 117 883 173
Unit 7
5-7 Barlow Street
South Townsville
Queensland, 4810
T +61 7 4724 4244
W rpsgroup.com

© COPYRIGHT PROTECTS THIS PLAN
Unauthorised reproduction or amendment not permitted.
Please contact the author.

client	Urbex
project	Somers & Hervey - Precinct 2
title	COVER SHEET
scale	1:5000 @ A1
project number	6967-P2
drawing number	CS.01
rev	11
northpoint	

PLANTING SCHEDULE

CODE	BOTANICAL NAME	COMMON NAME	MINIMUM POT SIZE	SPACING	STAKES AND GUYS	No. Required
Precinct 2 - Stage 3CCeX						
GROUND COVER						
CAR app	CAREX appressa	Tall Sedge	Tubestock	Refer Plans	NO	150
FIC nod	FICINIA nodosa	Club Rush	Tubestock	Refer Plans	NO	150
LOM hys	LOMANDRA hystrix	Spiny Matt Rush	Tubestock	Refer Plans	NO	300
Precinct 2 - Stage 3C						
TREE						
CUP ana	CUPANIOPSIS anacardioides	Tuckeroo	300mm	Refer Plans	YES	5
CUP ana	CUPANIOPSIS anacardioides	Tuckeroo	Tubestock	Refer Plans	YES	2
GRE bai	GREVILLEA baileyana	Brown Silky Oak	300mm	Refer Plans	YES	9
MIM ele	MIMUSOPS elengi	Spanish Cherry	300mm	Refer Plans	YES	14
SYZ hem	SYZYGium hemilamprum	Broad Leaved Lilly Pilly	300mm	Refer Plans	YES	9
SYZ hem	SYZYGium hemilamprum	Broad Leaved Lilly Pilly	Tubestock	Refer Plans	YES	1
TER ser	TERMINALIA sericocarpa	Bandicoot	Tubestock	Refer Plans	YES	8
Precinct 2 - Stage 3CC						
TREE						
CUP ana	CUPANIOPSIS anacardioides	Tuckeroo	Tubestock	Refer Plans	YES	15
SYZ hem	SYZYGium hemilamprum	Broad Leaved Lilly Pilly	Tubestock	Refer Plans	YES	14
TER ser	TERMINALIA sericocarpa	Bandicoot	Tubestock	Refer Plans	YES	13
GROUND COVER						
ERA elo	ERAGROTIS elongata	Clustered Lovegrass	Tubestock	Refer Plans	NO	490
GAH asp	GAHNIA aspera	Rough Saw-sedge	Tubestock	Refer Plans	NO	490
LOM hys	LOMANDRA hystrix	Spiny Matt Rush	Tubestock	Refer Plans	NO	980
Precinct 2 - Stage 4AA						
TREE						
CUP ana	CUPANIOPSIS anacardioides	Tuckeroo	300mm	Refer Plans	YES	2
CUP ana	CUPANIOPSIS anacardioides	Tuckeroo	Tubestock	Refer Plans	YES	80
GRE bai	GREVILLEA baileyana	Brown Silky Oak	300mm	Refer Plans	YES	4
SYZ hem	SYZYGium hemilamprum	Broad Leaved Lilly Pilly	300mm	Refer Plans	YES	2
SYZ hem	SYZYGium hemilamprum	Broad Leaved Lilly Pilly	Tubestock	Refer Plans	YES	74
TER ser	TERMINALIA sericocarpa	Bandicoot	Tubestock	Refer Plans	YES	96
GROUND COVER						
ERA elo	ERAGROTIS elongata	Clustered Lovegrass	Tubestock	Refer Plans	NO	738
GAH asp	GAHNIA aspera	Rough Saw-sedge	Tubestock	Refer Plans	NO	738
LOM hys	LOMANDRA hystrix	Spiny Matt Rush	Tubestock	Refer Plans	NO	1476
Precinct 2 - Stage 4B						
TREE						
CUP ana	CUPANIOPSIS anacardioides	Tuckeroo	300mm	Refer Plans	YES	6
GRE bai	GREVILLEA baileyana	Brown Silky Oak	300mm	Refer Plans	YES	7
MIM ele	MIMUSOPS elengi	Spanish Cherry	300mm	Refer Plans	YES	4
SYZ hem	SYZYGium hemilamprum	Broad Leaved Lilly Pilly	300mm	Refer Plans	YES	4
Precinct 2 - Stage 4C						
TREE						
CUP ana	CUPANIOPSIS anacardioides	Tuckeroo	300mm	Refer Plans	YES	8
GRE bai	GREVILLEA baileyana	Brown Silky Oak	300mm	Refer Plans	YES	8
MIM ele	MIMUSOPS elengi	Spanish Cherry	300mm	Refer Plans	YES	5
SYZ hem	SYZYGium hemilamprum	Broad Leaved Lilly Pilly	300mm	Refer Plans	YES	6
Precinct 2 - Stage 4CC						
TREE						
CUP ana	CUPANIOPSIS anacardioides	Tuckeroo	Tubestock	Refer Plans	YES	25
SYZ hem	SYZYGium hemilamprum	Broad Leaved Lilly Pilly	Tubestock	Refer Plans	YES	29
TER ser	TERMINALIA sericocarpa	Bandicoot	Tubestock	Refer Plans	YES	23
GROUND COVER						
ERA elo	ERAGROTIS elongata	Clustered Lovegrass	Tubestock	Refer Plans	NO	348
GAH asp	GAHNIA aspera	Rough Saw-sedge	Tubestock	Refer Plans	NO	348
LOM hys	LOMANDRA hystrix	Spiny Matt Rush	Tubestock	Refer Plans	NO	696
Precinct 2 - Stage 4D						
TREE						
CUP ana	CUPANIOPSIS anacardioides	Tuckeroo	300mm	Refer Plans	YES	5
GRE bai	GREVILLEA baileyana	Brown Silky Oak	300mm	Refer Plans	YES	4
MIM ele	MIMUSOPS elengi	Spanish Cherry	300mm	Refer Plans	YES	3
SYZ hem	SYZYGium hemilamprum	Broad Leaved Lilly Pilly	300mm	Refer Plans	YES	6
Precinct 2 - Stage 4DD						
TREE						
CUP ana	CUPANIOPSIS anacardioides	Tuckeroo	Tubestock	Refer Plans	YES	24
SYZ hem	SYZYGium hemilamprum	Broad Leaved Lilly Pilly	Tubestock	Refer Plans	YES	28
TER ser	TERMINALIA sericocarpa	Bandicoot	Tubestock	Refer Plans	YES	29
GROUND COVER						
ERA elo	ERAGROTIS elongata	Clustered Lovegrass	Tubestock	Refer Plans	NO	682
GAH asp	GAHNIA aspera	Rough Saw-sedge	Tubestock	Refer Plans	NO	682
LOM hys	LOMANDRA hystrix	Spiny Matt Rush	Tubestock	Refer Plans	NO	1360
Precinct 2 - Stage 4EE						

NOTE:
The contractor shall review the plant schedule to ensure that drawings and schedules concur. Where insufficient detail or discrepancies may exist on either the plans or the schedule, it is the contractors responsibility to resolve immediately with the Landscape Architect and prior to providing tender pricing, signed work contracts or commencement of works.

CODE	BOTANICAL NAME	COMMON NAME	MINIMUM POT SIZE	SPACING	STAKES AND GUYS	No. Required
TREE						
CUP ana	CUPANIOPSIS anacardioides	Tuckeroo	300mm	Refer Plans	YES	2
CUP ana	CUPANIOPSIS anacardioides	Tuckeroo	Tubestock	Refer Plans	YES	18
MIM ele	MIMUSOPS elengi	Spanish Cherry	300mm	Refer Plans	YES	2
SYZ hem	SYZYGium hemilamprum	Broad Leaved Lilly Pilly	300mm	Refer Plans	YES	3
SYZ hem	SYZYGium hemilamprum	Broad Leaved Lilly Pilly	Tubestock	Refer Plans	YES	18
TER ser	TERMINALIA sericocarpa	Bandicoot	Tubestock	Refer Plans	YES	9
GROUND COVER						
ERA elo	ERAGROTIS elongata	Clustered Lovegrass	Tubestock	Refer Plans	NO	184
GAH asp	GAHNIA aspera	Rough Saw-sedge	Tubestock	Refer Plans	NO	184
LOM hys	LOMANDRA hystrix	Spiny Matt Rush	Tubestock	Refer Plans	NO	368


8

AS CONSTRUCTED

I, Timothy Connor, Registered Landscape Architect (AILA #3037), of RPS AAP CONSULTING PTY LTD, hereby certify that the landscape construction works, as shown on these 'As Constructed' drawings, reflect the changes that were made during installation.


11	STAGE 3C - AS CONSTRUCTED	20260807	RKM	TFC
10	FOR CONSTRUCTION	20260717	LSG	TFC
9	AMENDED FOR CONSTRUCTION	20260629	RKM	TFC
8	FOR CONSTRUCTION	20260325	RKM	TFC
7	AMENDED OPW	20250828	RKM	TFC
6	AMENDED ISSUE	20241025	LRF	TFC
5	AMENDED ISSUE	20240910	BGS	TFC
4	AMENDED ISSUE	20240903	BGS	TFC
3	AMENDED ISSUE	20240902	BGS	TFC
2	AMENDED ISSUE	20240419	BGS	TFC
1	INITIAL ISSUE	20240412	BGS	TFC
rev no	description	date	drawn	approved

PLEASE NOTE:
Annotiated dimensions take precedence over scaled dimensions. Contractors are to verify all dimensions on site before commencing any work or producing shop drawings. These drawings are protected by copyright and may not be copied or reproduced without the written permission of RPS' management. Refer to L0.00 (cover sheet) for RPS drawing disclaimer!

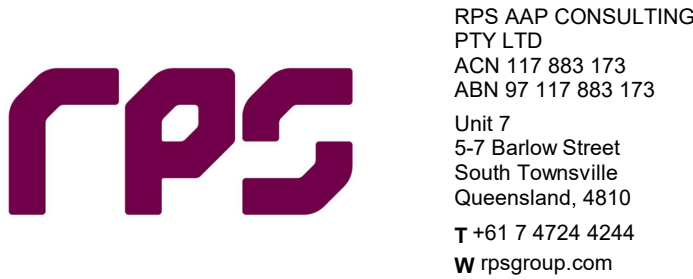

© COPYRIGHT PROTECTS THIS PLAN
Unauthorised reproduction or amendment not permitted.
Please contact the author.

client		Urbex	
project		Somers & Hervey - Precinct 2	
title		PLANT SCHEDULE	
scale			
project number	6967-P2		northpoint
drawing number	CS.02	rev	11

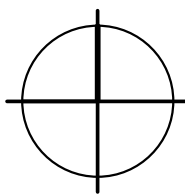


MATERIALS & FINISHES SCHEDULE

Code / Item	Manuf. / Supplier	Requirements / Comments
Site Prep		
Erosion and silt control measures		Refer construction site management plan
Site set-up (all landscape)		Advise location of site shed if applicable
Supply of temporary power and water		During the contruction period
Tree protection fence		Refer TCC specification
Earthworks		
Excavation/ Filling to adjust civil profiles		To adjust civil profiles to desired shape and trim.
Grading and Trim (all landscape)		All landscape- Assumes bulk levels are left within 150-300mm of required finished levels 150mm assumed for turf 300mm assumed for planting
Hardscape		
PT1 - Pavement Type 01		Type: Plain Coloured Broom Finish Concrete Aggregate: to AS1379 Finish: Light broom finish - samples to be approved Slip Resistance: P4 Wet Pendulum Test refer AS HB 198 Joints: Expansion and contraction joints to TCC standard detail SD070 or SD075. All dimensions to conform with AS1428.1 Tolerances.
RP - Rock Protection		Type: Rock Protection Refer civil engineer's plans for details
Other		
Root Barrier		Type: Nylex General Products “Root Barrier” HDPE, or approved equivalent. Roll Width: 900mm Minimum Width: 3000mm and 1500mm from centre of tree.
Softscape		
H1 - Hydromulch Type 1		Type: Hydromulch - Blue Couch Mix Horizon A: (subject to soil testing) Ripped insitu subsoil with addition of: - Gypsum @ 1000g/m2 - Agricultural Lime @ 150g/m2 - Composted Cow Manure @ 5000g/m2 Depth:150mm consolidated depth
H2 - Hydromulch Type 2		Type: Hydromulch - Native Mix with Tubes Horizon A: (subject to soil testing) Ripped insitu subsoil with addition of: - Gypsum @ 1000g/m2 - Agricultural Lime @ 150g/m2 - Composted Cow Manure @ 5000g/m2 Depth:150mm consolidated depth
M1 - Mulch Type 01		Type: Mulch on Ground Imported weathered hoop pine chip bark Depth: 100mm - Refer to specifications for details.
PA3 - Planting Area Type 3		Type: Planting Area Over Natural Ground Mulch: Imported weathered hoop pine chip bark Depth: 100mm - Refer to specifications for details. Jute Mesh: open weave (470g/square meter) pinned a maximum 1m centres with minimum 300mm long U shaped Bio-pins. Cut Jute mesh as per locations shown on P2-LD.02. Horizon A: Soil Classification: Landscape Soils (on Grade) per section 5.1 of AS4419 (2018). Organic matter: Medium Organic Content Per Table 1 of AS4419 (2018) Phosphorus: Low Phosphorus Per Table 1 of AS4419 (2018) pH: Neutral Soil Per section 5.2 of AS4419 (2018) Soil Grade: Sandy loam, fine Sandy Loam or Loam in accordance with table K1 of AS4419 (2018) Depth: 150mm consolidated depth Or equal plant media certified as "fit for purpose" by qualified soil scientist, agronomist or analyst in accordance with the specifications and approved by the Contract Administrator. Horizon B: (subject to soil testing) Ripped insitu subsoil with addition of: - Gypsum @ 1000g/m2 - Agricultural Lime @ 150g/m2 - Composted Cow Manure @ 5000g/m2 Depth:150mm consolidated depth Subsoil drainage: As required at surface inverts and base of slopes where water table intercepted by walls, pavements and edges, plumbed to storm water.

Code / Item	Manuf. / Supplier	Requirements / Comments
TF1 - Turf on Ground		Type: Turf over natural ground Species: min 95% Couch 25mm thick – First grade, 100% cover. Horizon A: Soil Classification: Soils for turf and lawns Per section 5.1 of AS4419 (2018). Organic matter: Percentage to requirements of “Sport Fields” Per Table 3 of AS4419 (2018). Phosphorus: levels to requirements of “Sport Fields” Per Table 3 of AS4419 (2018) pH: Neutral Soil Per section 5.2 of AS4419 (2018) Depth: 100mm consolidated depth Or equal plant media certified as "fit for purpose" by qualified soil scientist, agronomist or analyst in accordance with the specifications and approved by the Contract Administrator. Horizon B: (subject to soil testing) Ripped insitu subsoil with addition of: - Gypsum @ 1000g/m2 - Agricultural Lime @ 150g/m2 - Composted Cow Manure @ 5000g/m2 Depth:150mm consolidated depth Subsoil drainage: As required at surface inverts and base of slopes where water table intercepted by walls, pavements and edges, plumbed to stormwater.
TF2 - Reinforced Turf		Type: Reinforced Turf Area Species: "Empire" Zoysia 25mm thick – First grade, 100% cover installed with: Bodpave 85 Paver Cells to reinforcing product manufacturers requirements. Horizon A: Soil Classification: Soils for turf and lawns Per section 5.1 of AS4419 (2018). Organic matter: Percentage to requirements of “Sport Fields” Per Table 3 of AS4419 (2018). Phosphorus: levels to requirements of “Sport Fields” Per Table 3 of AS4419 (2018) pH: Neutral Soil Per section 5.2 of AS4419 (2018) Depth: 50-70mm to Or equal plant media certified as "fit for purpose" by qualified soil scientist, agronomist or analyst in accordance with the specifications and approved by the Contract Administrator. Horizon B: Compacted base to reinforcing product manufacturers requirements.
Edging		
E1 - Edge Type 1		Continuous concrete Edge Sizing: 150mm x 150mm Tool Joint Spacing: 2500mm max Expansion Joint Spacing: 10000mm max
Fences		
F1 - Fence Type 1		Refer detail P2LD.03
F2 - Fence Type 2		Refer detail P2LD.04
Handrails		
HR1 - Handrail Type 1		Refer Civil Engineers Details

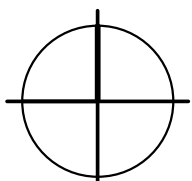

8	STAGE 3C - AS CONSTRUCTED	20260807	RKM	TFC	
7	FOR CONSTRUCTION	20260717	LSG	TFC	
6	FOR CONSTRUCTION	20260325	RKM	TFC	
5	AMENDED OPW	20250828	RKM	TFC	
4	AMENDED ISSUE	20241025	LRF	TFC	
3	AMENDED ISSUE	20240910	BGS	TFC	
2	AMENDED ISSUE	20240903	BGS	TFC	
1	AMENDED ISSUE	20240902	BGS	TFC	
rev no	description	date	drawn	approved	
PLEASE NOTE: Annotated dimensions take precedence over scaled dimensions. Contractors are to verify all dimensions on site before commencing any work or producing shop drawings. These drawings are protected by copyright and may not be copied or reproduced without the written permission of RPS' management. Refer to L0.00 (cover sheet) for RPS drawing disclaimer!					
			RPS AAP CONSULTING PTY LTD ACN 117 883 173 ABN 97 117 883 173 Unit 7 5-7 Barlow Street South Townsville Queensland, 4810 T +61 7 4724 4244 W rpsgroup.com		
			© COPYRIGHT PROTECTS THIS PLAN Unauthorised reproduction or amendment not permitted. Please contact the author.		
			client Urbex		
			project Somers & Hervey - Precinct 2		
			title MATERIALS AND FINISHES		
			scale		
project number 6967-P2			northpoint 		
drawing number CS.03		rev 8			

LEGEND

FENCING

- F1 F1 - FENCING TYPE 1
- F2 F2 - FENCING TYPE 2
- F4 F4 - FENCING TYPE 4
Existing fencing to be retained
- F5 F5 - FENCING TYPE 5
Existing fencing to be retained

AS CONSTRUCTED

I, Timothy Connor, Registered Landscape Architect (AILA #3037), of RPS AAP CONSULTING PTY LTD, hereby certify that the landscape construction works, as shown on these 'As Constructed' drawings, reflect the changes that were made during installation.

rev no	description	date	drawn	approved
12	STAGE 3C - AS CONSTRUCTED	20260807	RKM	TFC
11	FOR CONSTRUCTION	20260717	LSG	TFC
10	AMEND PATHWAY 3C	20260710	TFC	TFC
9	FOR CONSTRUCTION	20260325	RKM	TFC
8	AMENDED ISSUE	20250904	RKM	TFC
7	AMENDED OPW	20250828	RKM	TFC
6	REVISED ISSUE	20250401	RKM	TFC
5	AMENDED ISSUE	20241025	LRF	TFC
4	AMENDED ISSUE	20240910	BGS	TFC
3	AMENDED ISSUE	20240902	BGS	TFC
2	AMENDED ISSUE	20240419	BGS	TFC
1	INITIAL ISSUE	20240412	BGS	TFC

PLEASE NOTE:
Annotated dimensions take precedence over scaled dimensions. Contractors are to verify all dimensions on site before commencing any work or producing shop drawings. These drawings are protected by copyright and may not be copied or reproduced without the written permission of RPS' management. Refer to L0.00 (cover sheet) for RPS drawing disclaimer!



© COPYRIGHT PROTECTS THIS PLAN
Unauthorised reproduction or amendment not permitted.
Please contact the author.

RPS AAP CONSULTING
PTY LTD
ACN 117 883 173
ABN 97 117 883 173
Unit 7
5-7 Barlow Street
South Townsville
Queensland, 4810
T +61 7 4724 4244
W rpsgroup.com

client	Urbex
project	Somers & Hervey - Precinct 2
title	LANDSCAPE PLAN 1 OF 1
scale	1 : 500 0m 5 10 15 20 25 30
project number	6967-P2
drawing number	S3C-LP.01
rev	12

